
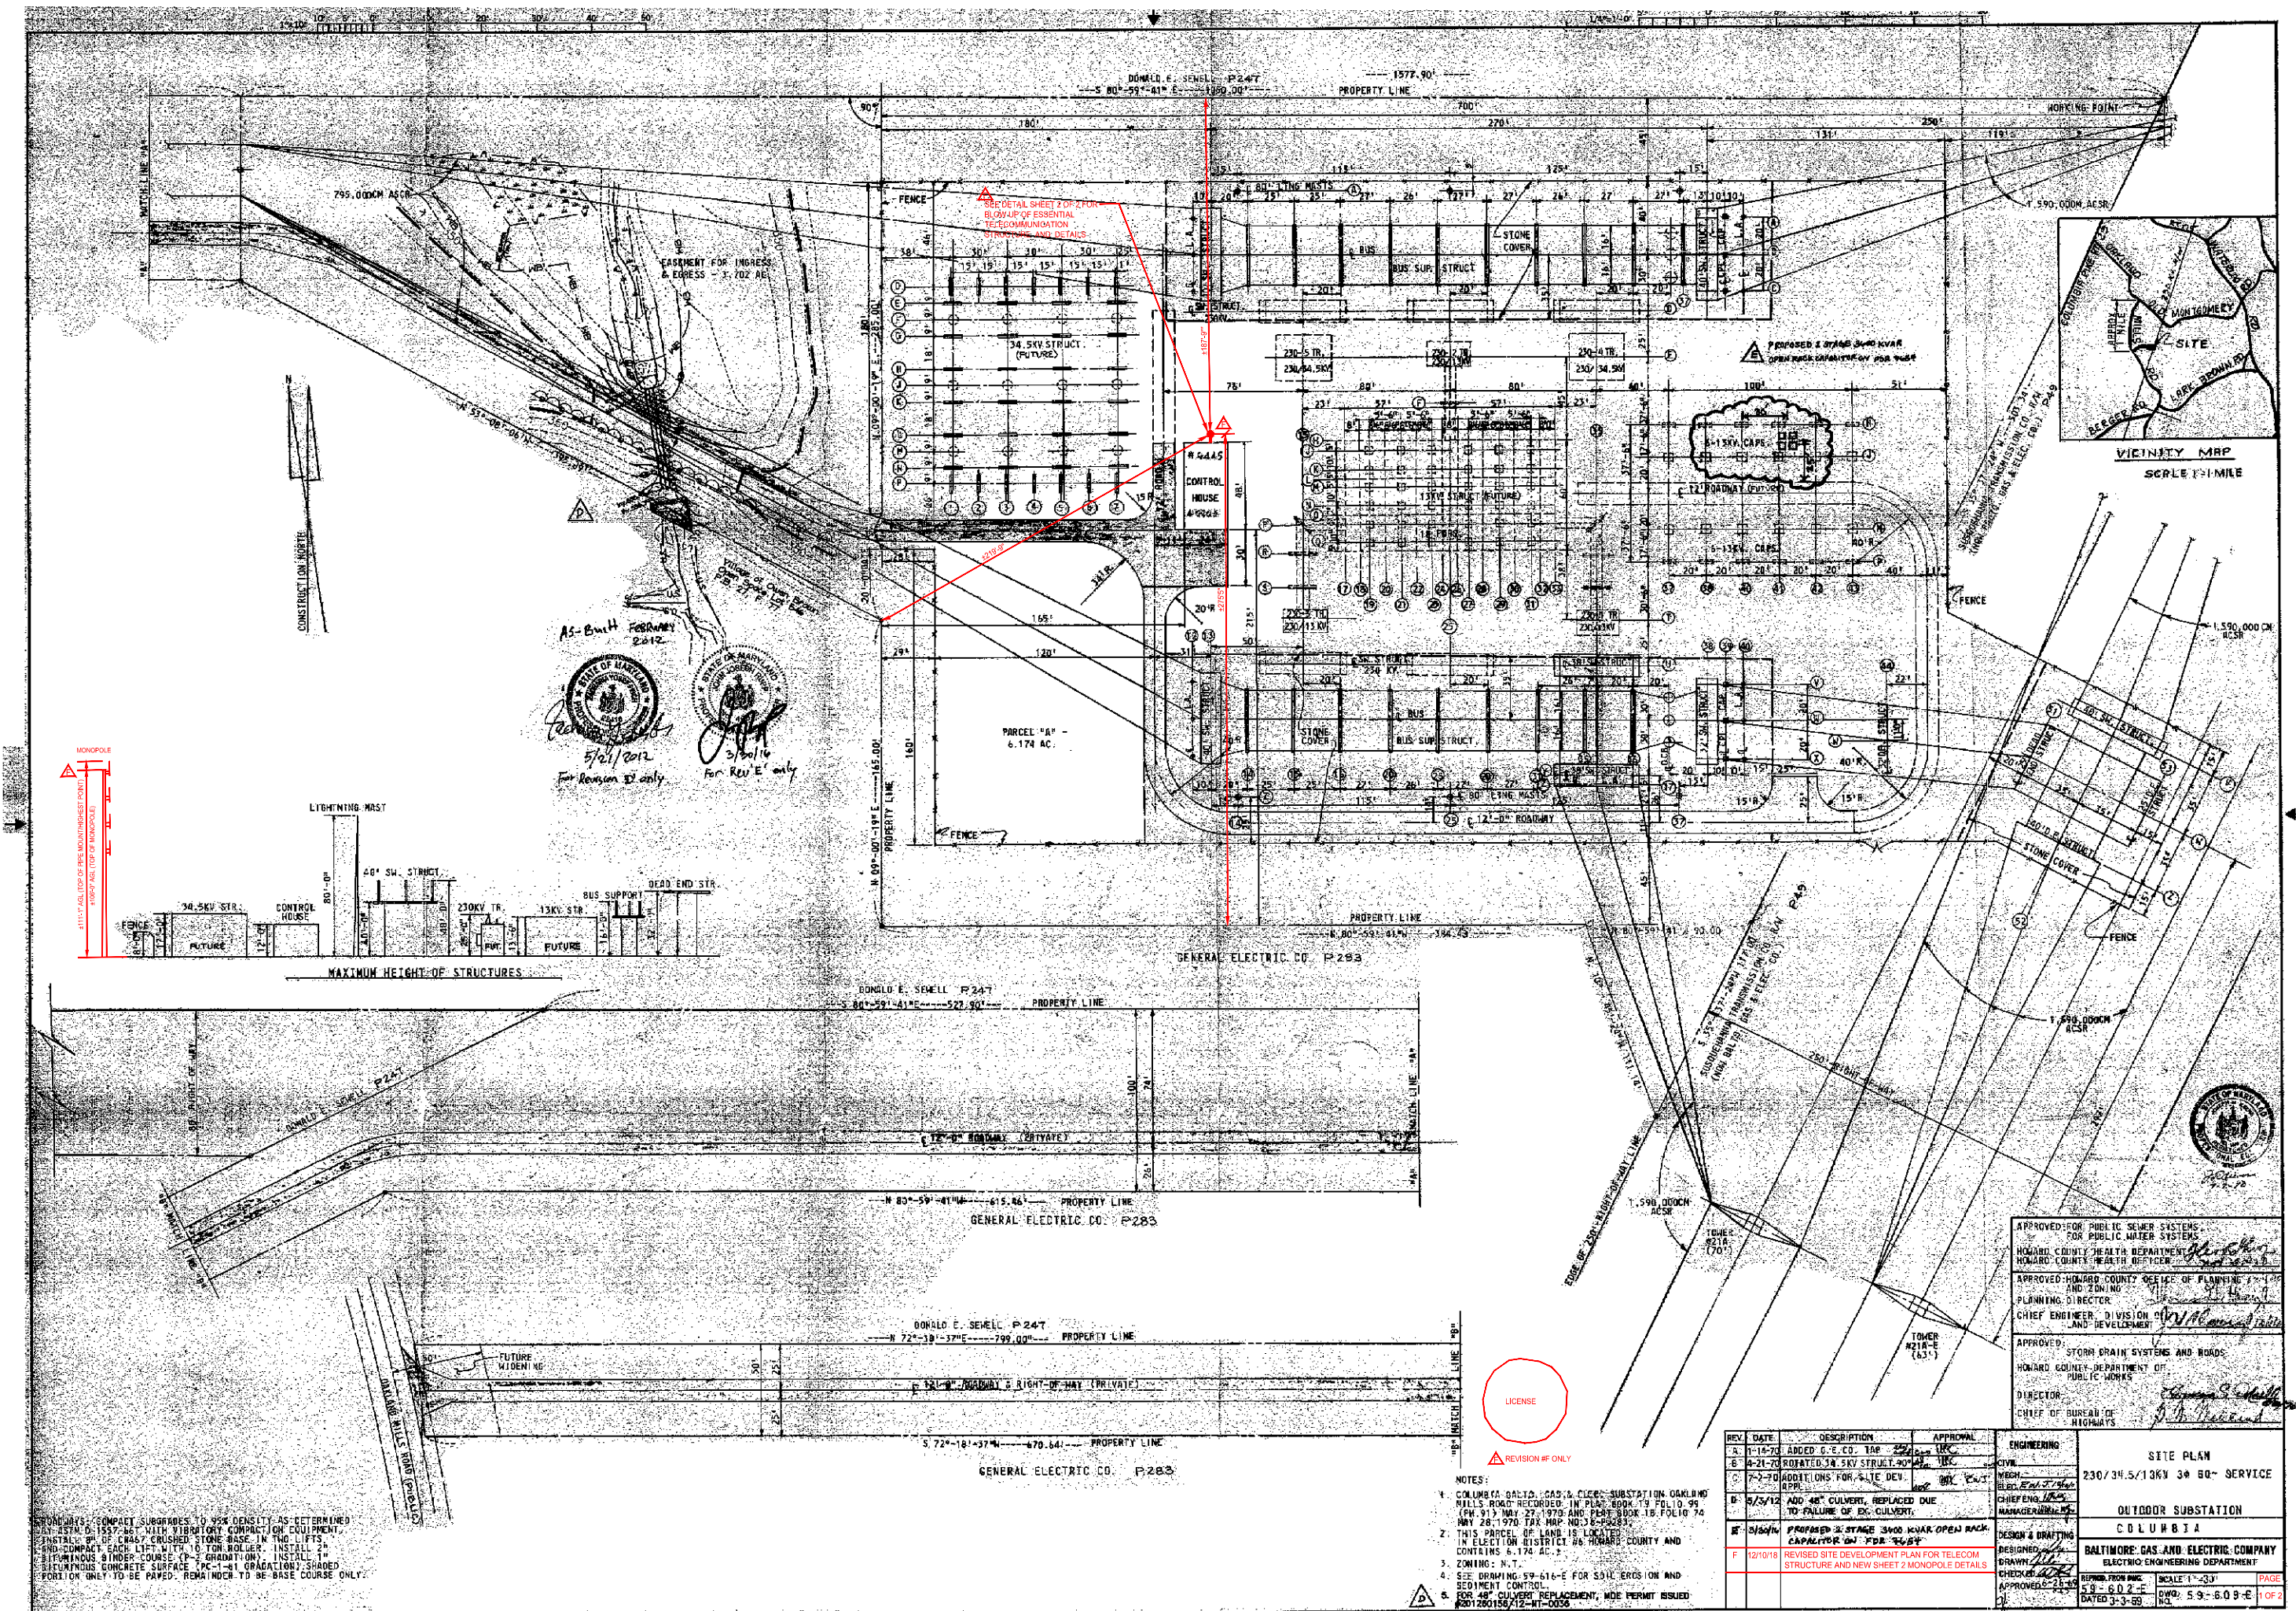


VIICINITY MAP
SCALE 1/4 MILE

As-Built FEBRUARY 2012
5/21/2012
For Revision D only

3/30/14
For Rev E only

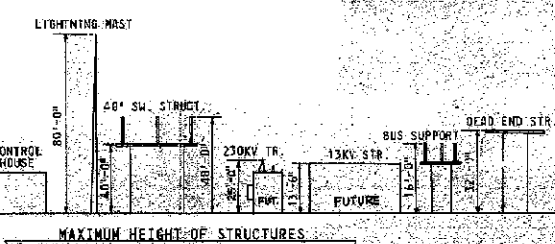

APPROVED FOR PUBLIC SEWER SYSTEMS
FOR PUBLIC WATER SYSTEMS
HOWARD COUNTY HEALTH DEPARTMENT
HOWARD COUNTY HEALTH OFFICER

APPROVED HOWARD COUNTY OFFICE OF PLANNING
AND ZONING
PLANNING DIRECTOR

CHIEF ENGINEER DIVISION OF
LAND DEVELOPMENT

APPROVED: STORM DRAIN SYSTEMS AND ROADS
HOWARD COUNTY DEPARTMENT OF
PUBLIC WORKS
DIRECTOR

CHIEF OF BUREAU OF HIGHWAYS

REV	DATE	DESCRIPTION	APPROVAL	ENGINEERING	SITE PLAN
A	1-14-70	ADDED G.E. CO. 1AP	220	INC	230/34.5/13KV 3Ø 60° SERVICE
B	4-21-70	ROTATED 34.5KV STR. 90°	220	INC	
C	7-2-70	ADDITIONS FOR SITE DEV.	220	INC	
D	5/5/12	ADD 48" CULVERT, REPLACED DUE TO FAILURE OF EX. CULVERT.	220	INC	
E	3/30/14	PROPOSED 3-STAGE 3400 KWAR-OPEN BACK CAPACITOR ON FDR 34.5KV	220	INC	
F	12/10/18	REVISED SITE DEVELOPMENT PLAN FOR TELECOM STRUCTURE AND NEW SHEET 2 MONOPOLE DETAILS	220	INC	

DESIGN & DRAFTING	DESIGNED BY	BALTIMORE GAS AND ELECTRIC COMPANY
DRAWN BY	ELECTRIC ENGINEERING DEPARTMENT	
CHECKED BY	59-602-E	
APPROVED BY	DATED 3-3-59	

SCALE 1"=30'
DWG. 59-609-E
PAGE 1 OF 2

- NOTES:
- COLUMBIA BALD. ROAD CLEC. SUBSTATION OAKLAND HILLS ROAD RECORDED IN PLAT BOOK 18 FOLIO 94 (PH. 91) MAY 27, 1970 AND PLAT BOOK 18 FOLIO 74 MAY 28, 1970 TAX MAP NO. 38-P-283.
 - THIS PARCEL OF LAND IS LOCATED IN ELECTION DISTRICT 86 HOWARD COUNTY AND CONTAINS 6.174 AC.
 - ZONING: N.T.
 - SEE DRAWING 59-616-E FOR SOIL EROSION AND SEDIMENT CONTROL.
 - FOR 48" CULVERT REPLACEMENT, MDE PERMIT ISSUED #20120156712-WT-0055

ROADWAYS, COMPACT SUBGRADES TO 4% DENSITY AS DETERMINED BY ASTM D 1557-96c WITH VIBRATORY COMPACTION EQUIPMENT. INSTALL 8" OF CR467 CRUSHED STONE BASE IN TWO LIFTS AND COMPACT EACH LIFT WITH 10 TON ROLLER. INSTALL 2" BITUMINOUS SAND COURSE. (1) GRADATION. INSTALL 1" BITUMINOUS CONCRETE SURFACE (PC-1-61 GRADATION) SHADED PORTION ONLY TO BE PAVED. REMAINDER TO BE BASE COURSE ONLY.

